

051 13
 052 35
 053 11
 054 3

REVISION DATE
 1/15/2016

POR. NE1/4 SEC.31 T.3N., R.17E., M.D.B.&M.


Tax Rate Area
 76-015

31-05

F = Full Time

1 = 6/22/2018 7:45 PM Friday

1" = 100'

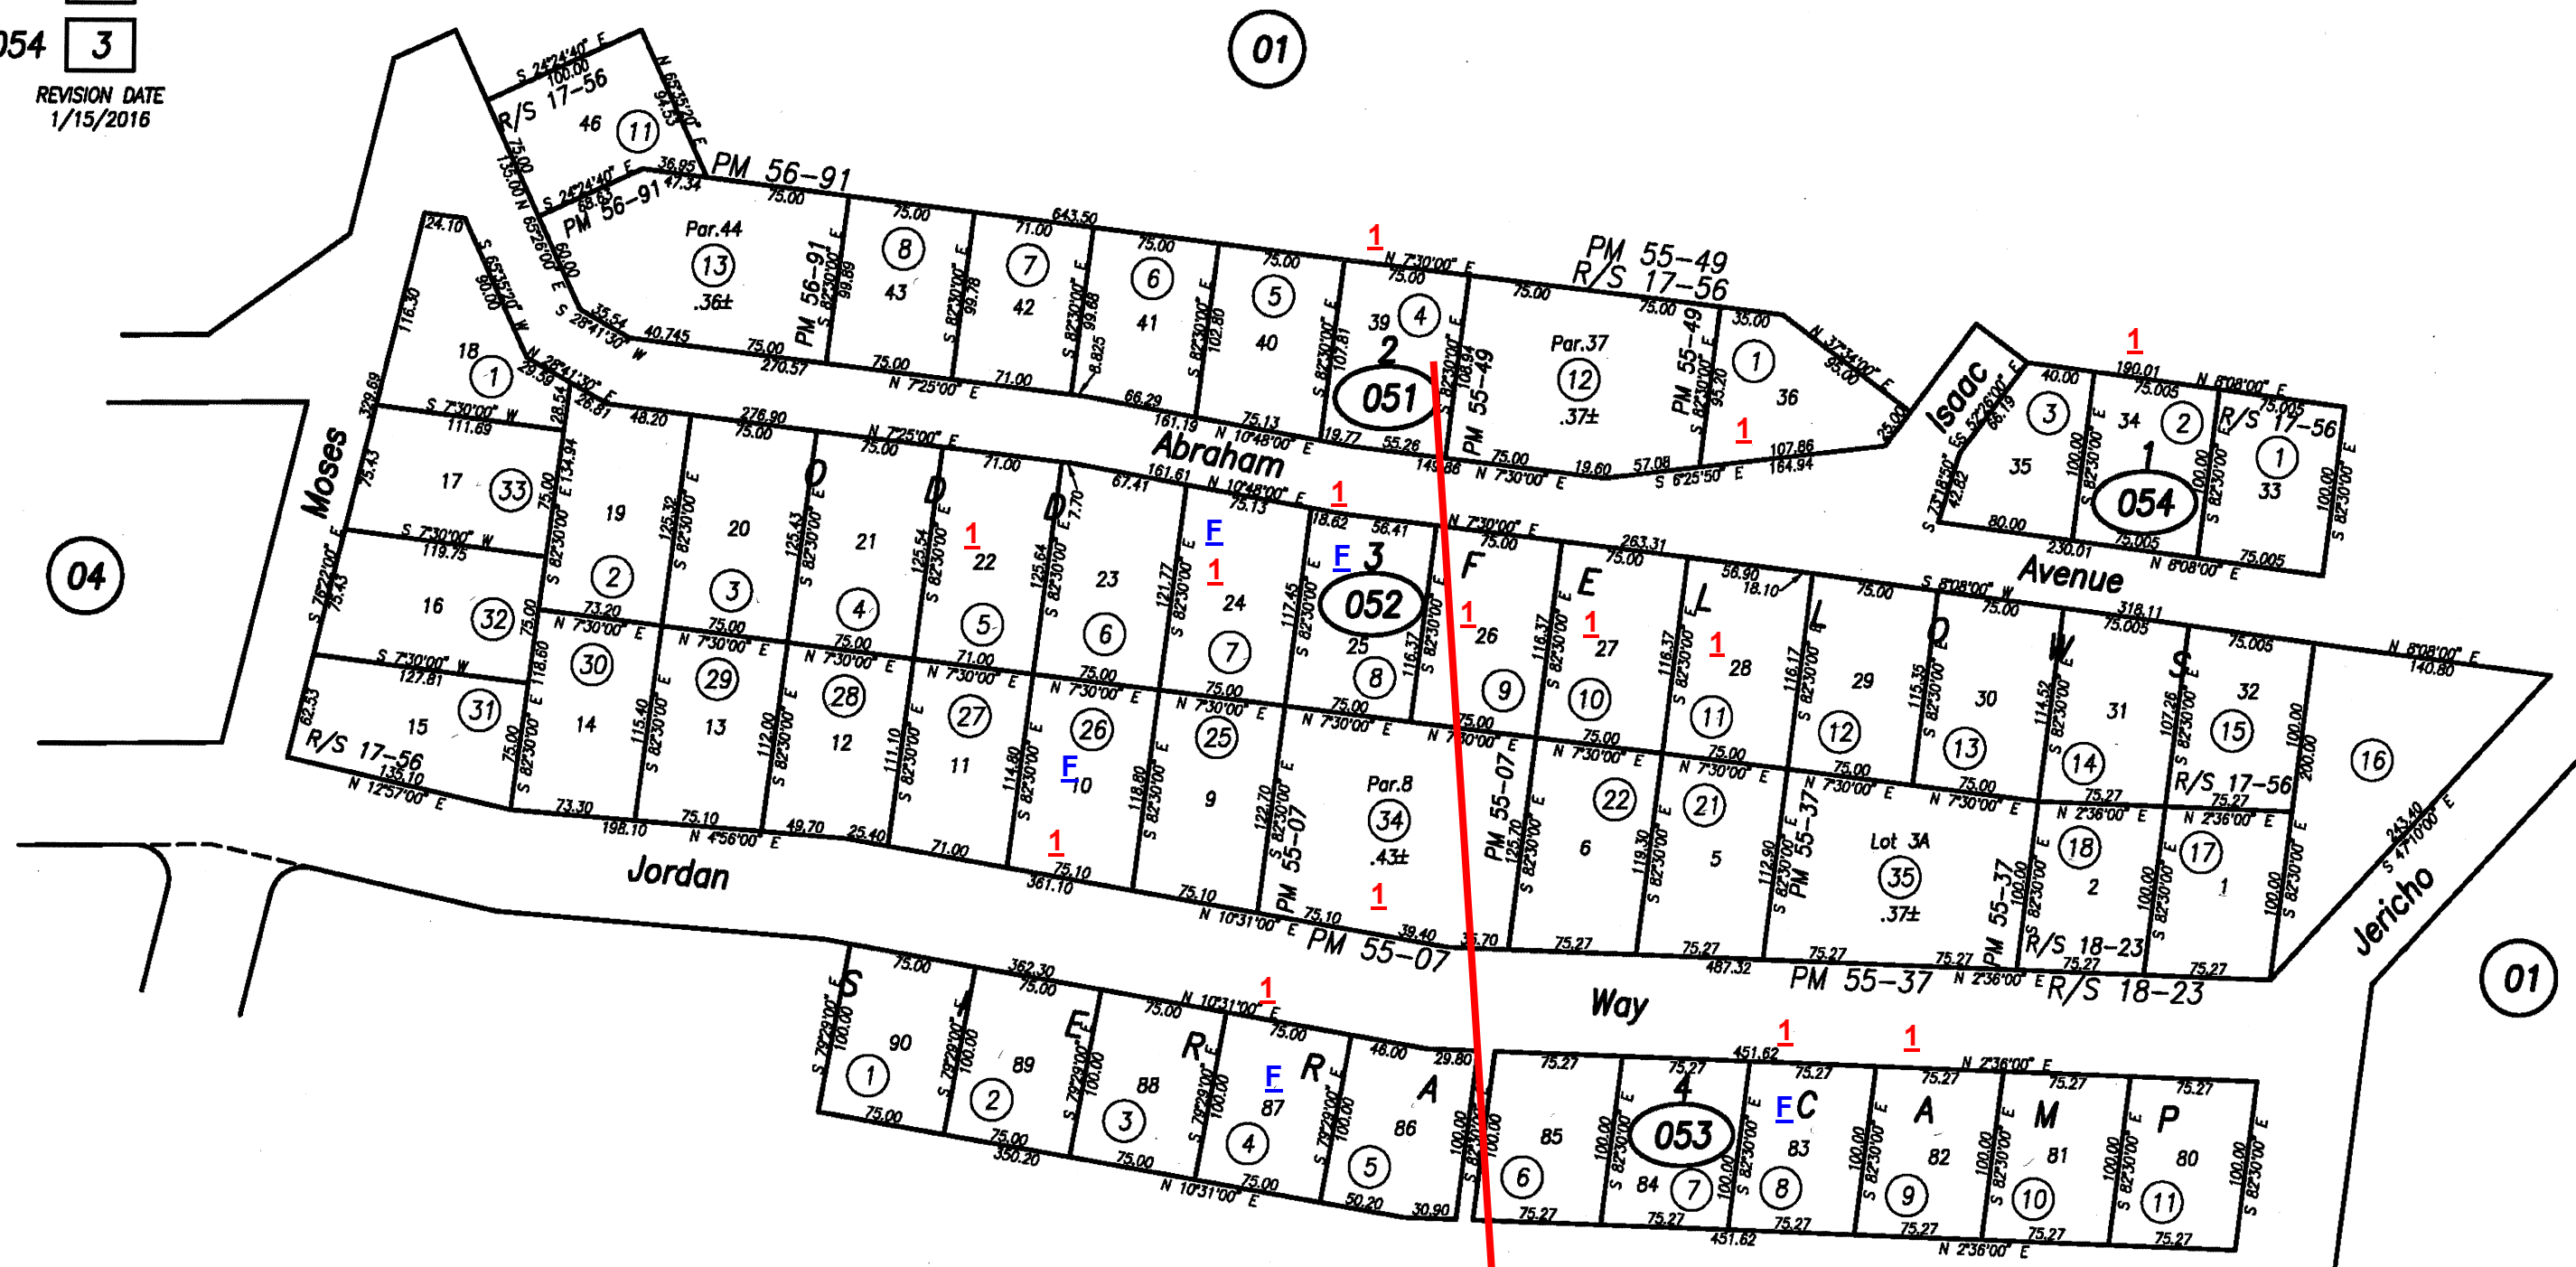

Note: Assessor's Block Numbers Shown In Ellipses
 Assessor's Lot Numbers Shown In Circles

Note: This Plat Is For Assessment Purposes
 Only And Not An Official Map.
 Copyright ©1998 by Tuol. Co. Assessor

Symbol connects Assessor Parcels currently
 separated for tax purposes, but makeup a
 single legal parcel.

RF Path

Assessor's Map
 31-05
 County of Tuolumne, Calif.
 1949

Odd Fellows Sierra Camp Sub. No.1, M.O.R. Bk.10 Pg.46